


From: [Phan, Johnny](#)
To: [Downtown West Project](#)
Subject: FW: Preliminary Draft D1 - H1, H5, H6 exhibits
Date: Tuesday, April 6, 2021 3:02:51 PM
Attachments: [Exhibit D1 - Site Plan Exhibit - City Markup.pdf](#)

From: Phan, Johnny
Sent: Tuesday, March 23, 2021 3:47 PM
To: Miller, J. Gregg <gmliller@coblentzlaw.com>; Straka, Stephanie <SStraka@coblentzlaw.com>
Subject: Preliminary Draft D1 - H1, H5, H6 exhibits


Johnny V. Phan


Chief Deputy City Attorney
Office of the City Attorney
City of San Jose
200 East Santa Clara Street
San Jose, CA 95113-1905
Main Ph: (408) 535-1900
Direct No.: (408) 535-1981
Fax No. (408) 998-3131


NOTICE TO RECIPIENT: This communication is intended **only** for the person to whom it is addressed, and may be protected by law. If you receive this in error, any review, use, dissemination, distribution, or copying is strictly prohibited. Please notify us immediately of the error and delete this communication and any attached documents from your system. Thank you for your cooperation.

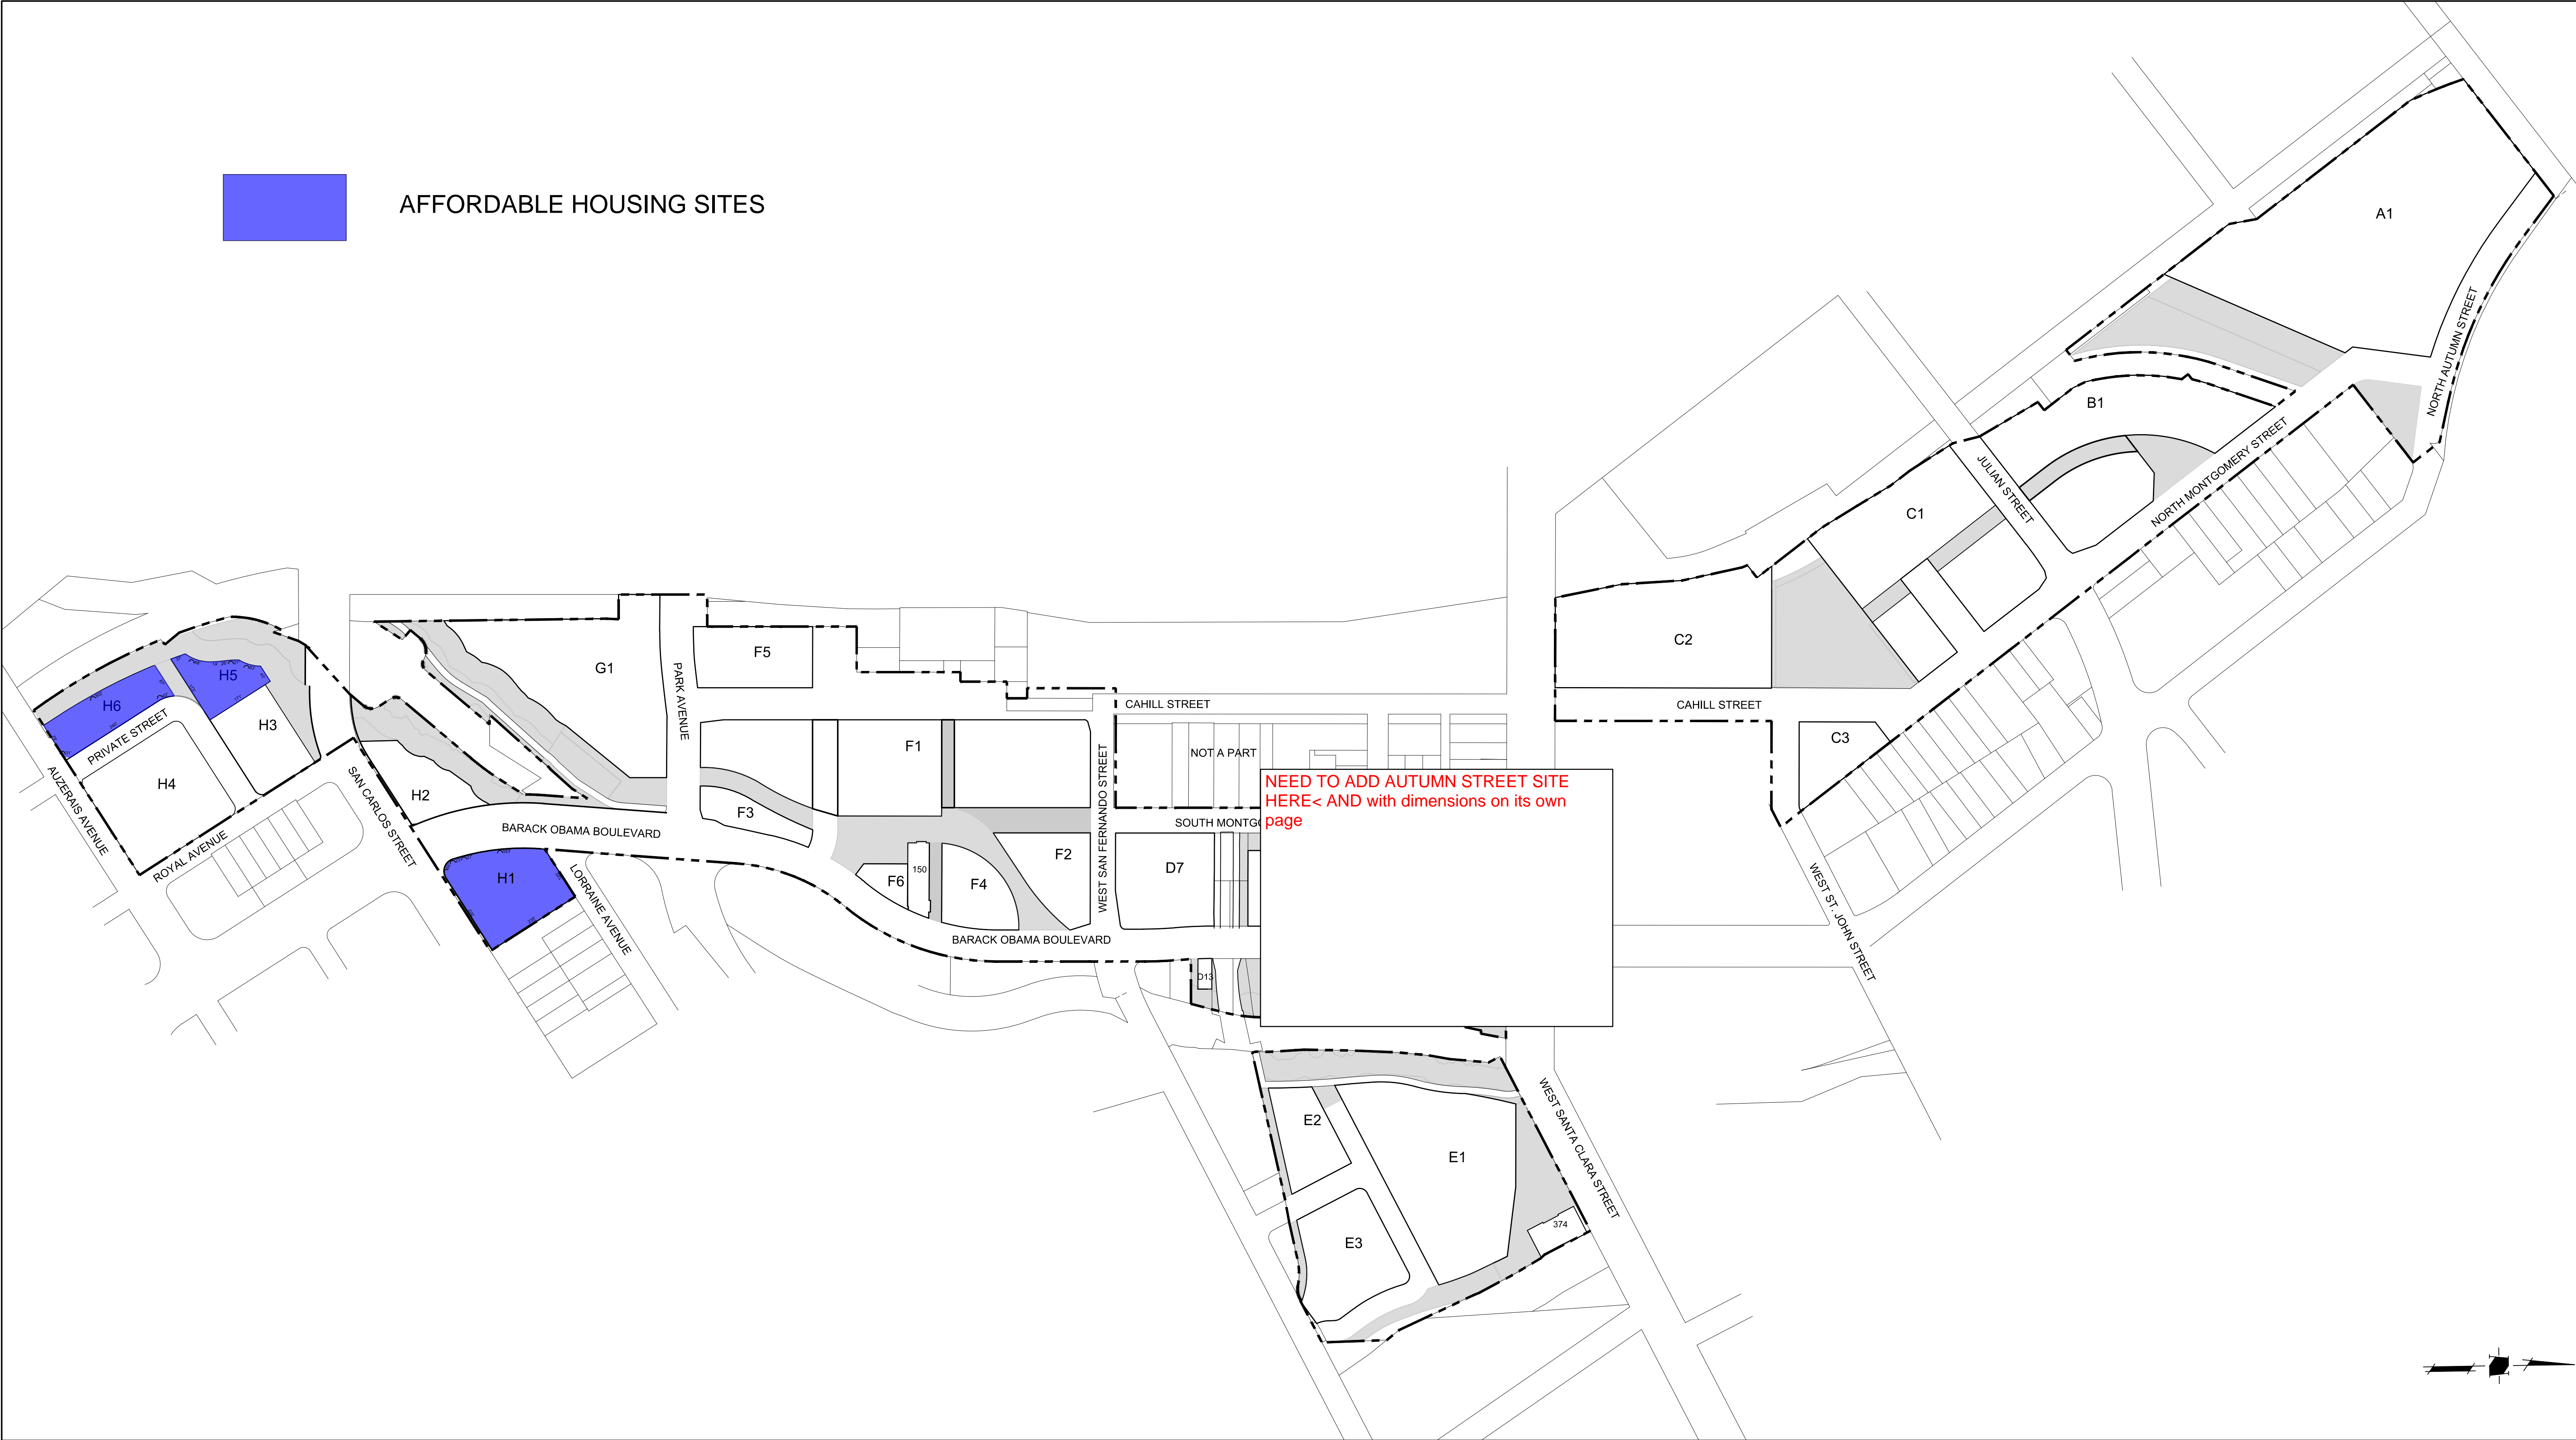

PROJECT SITE PLAN GENERALLY DEPICTING LOCATION OF H1, H5, and H6 PROPERTIES

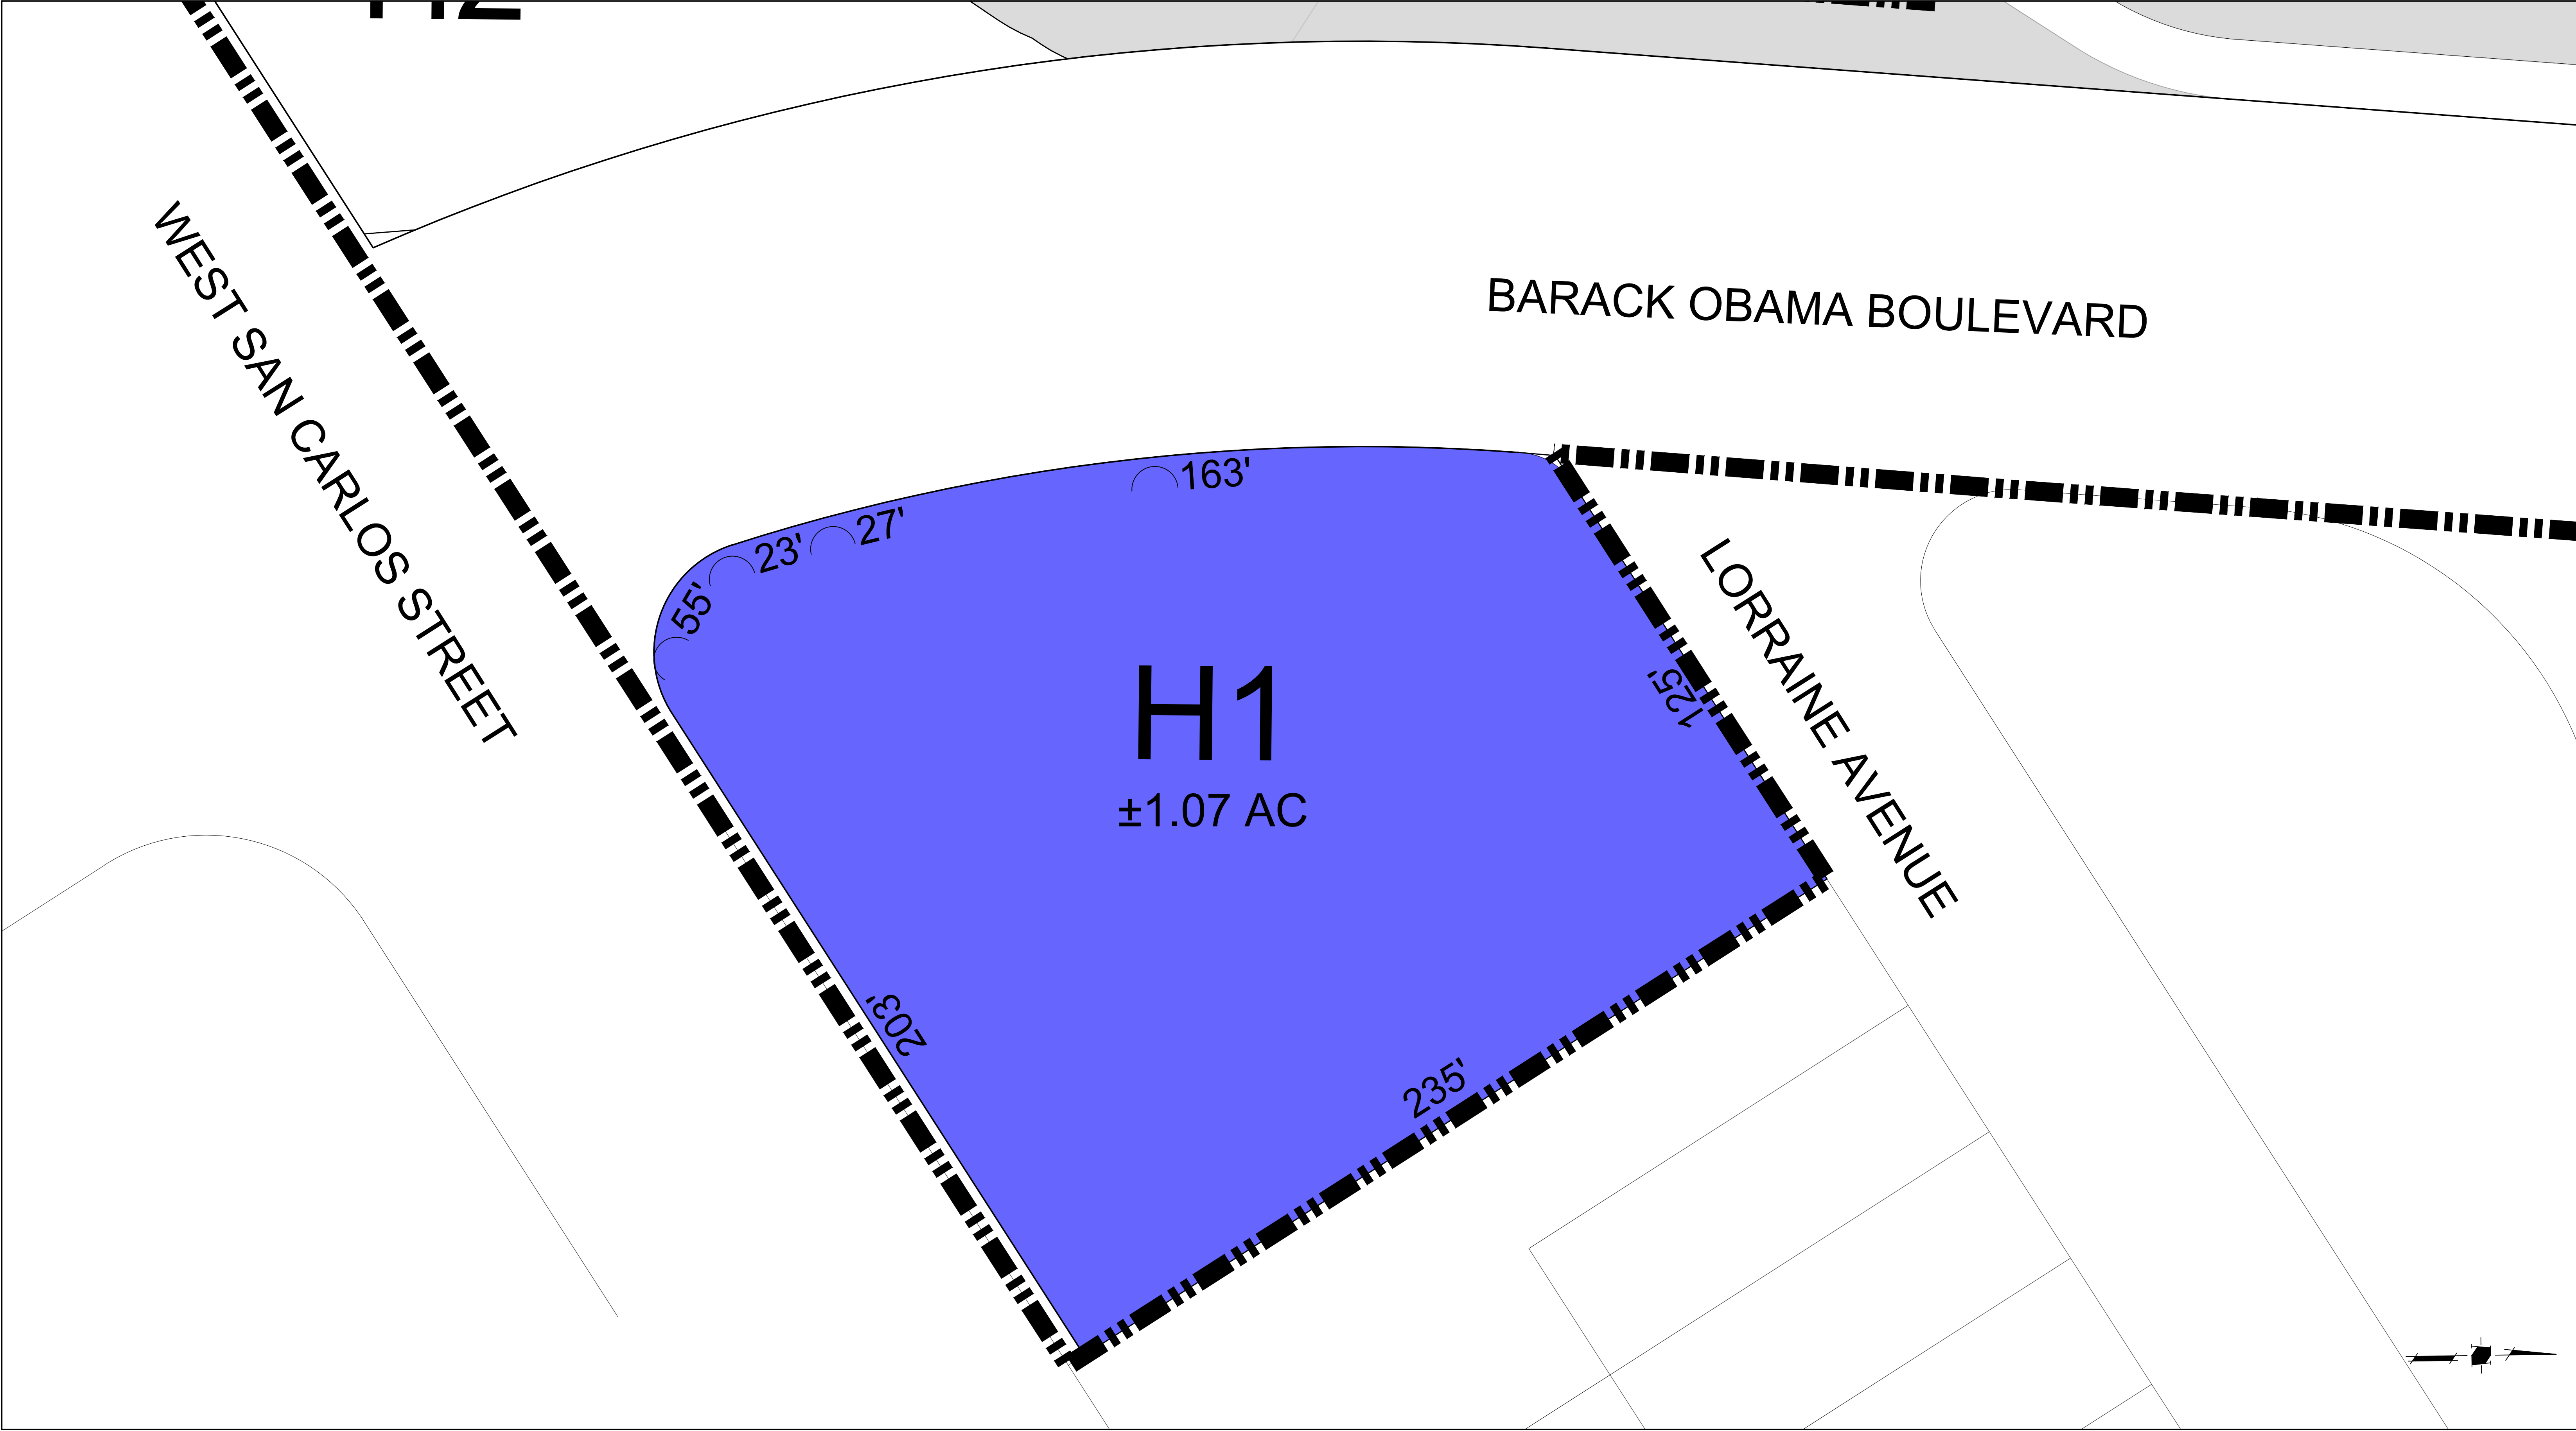

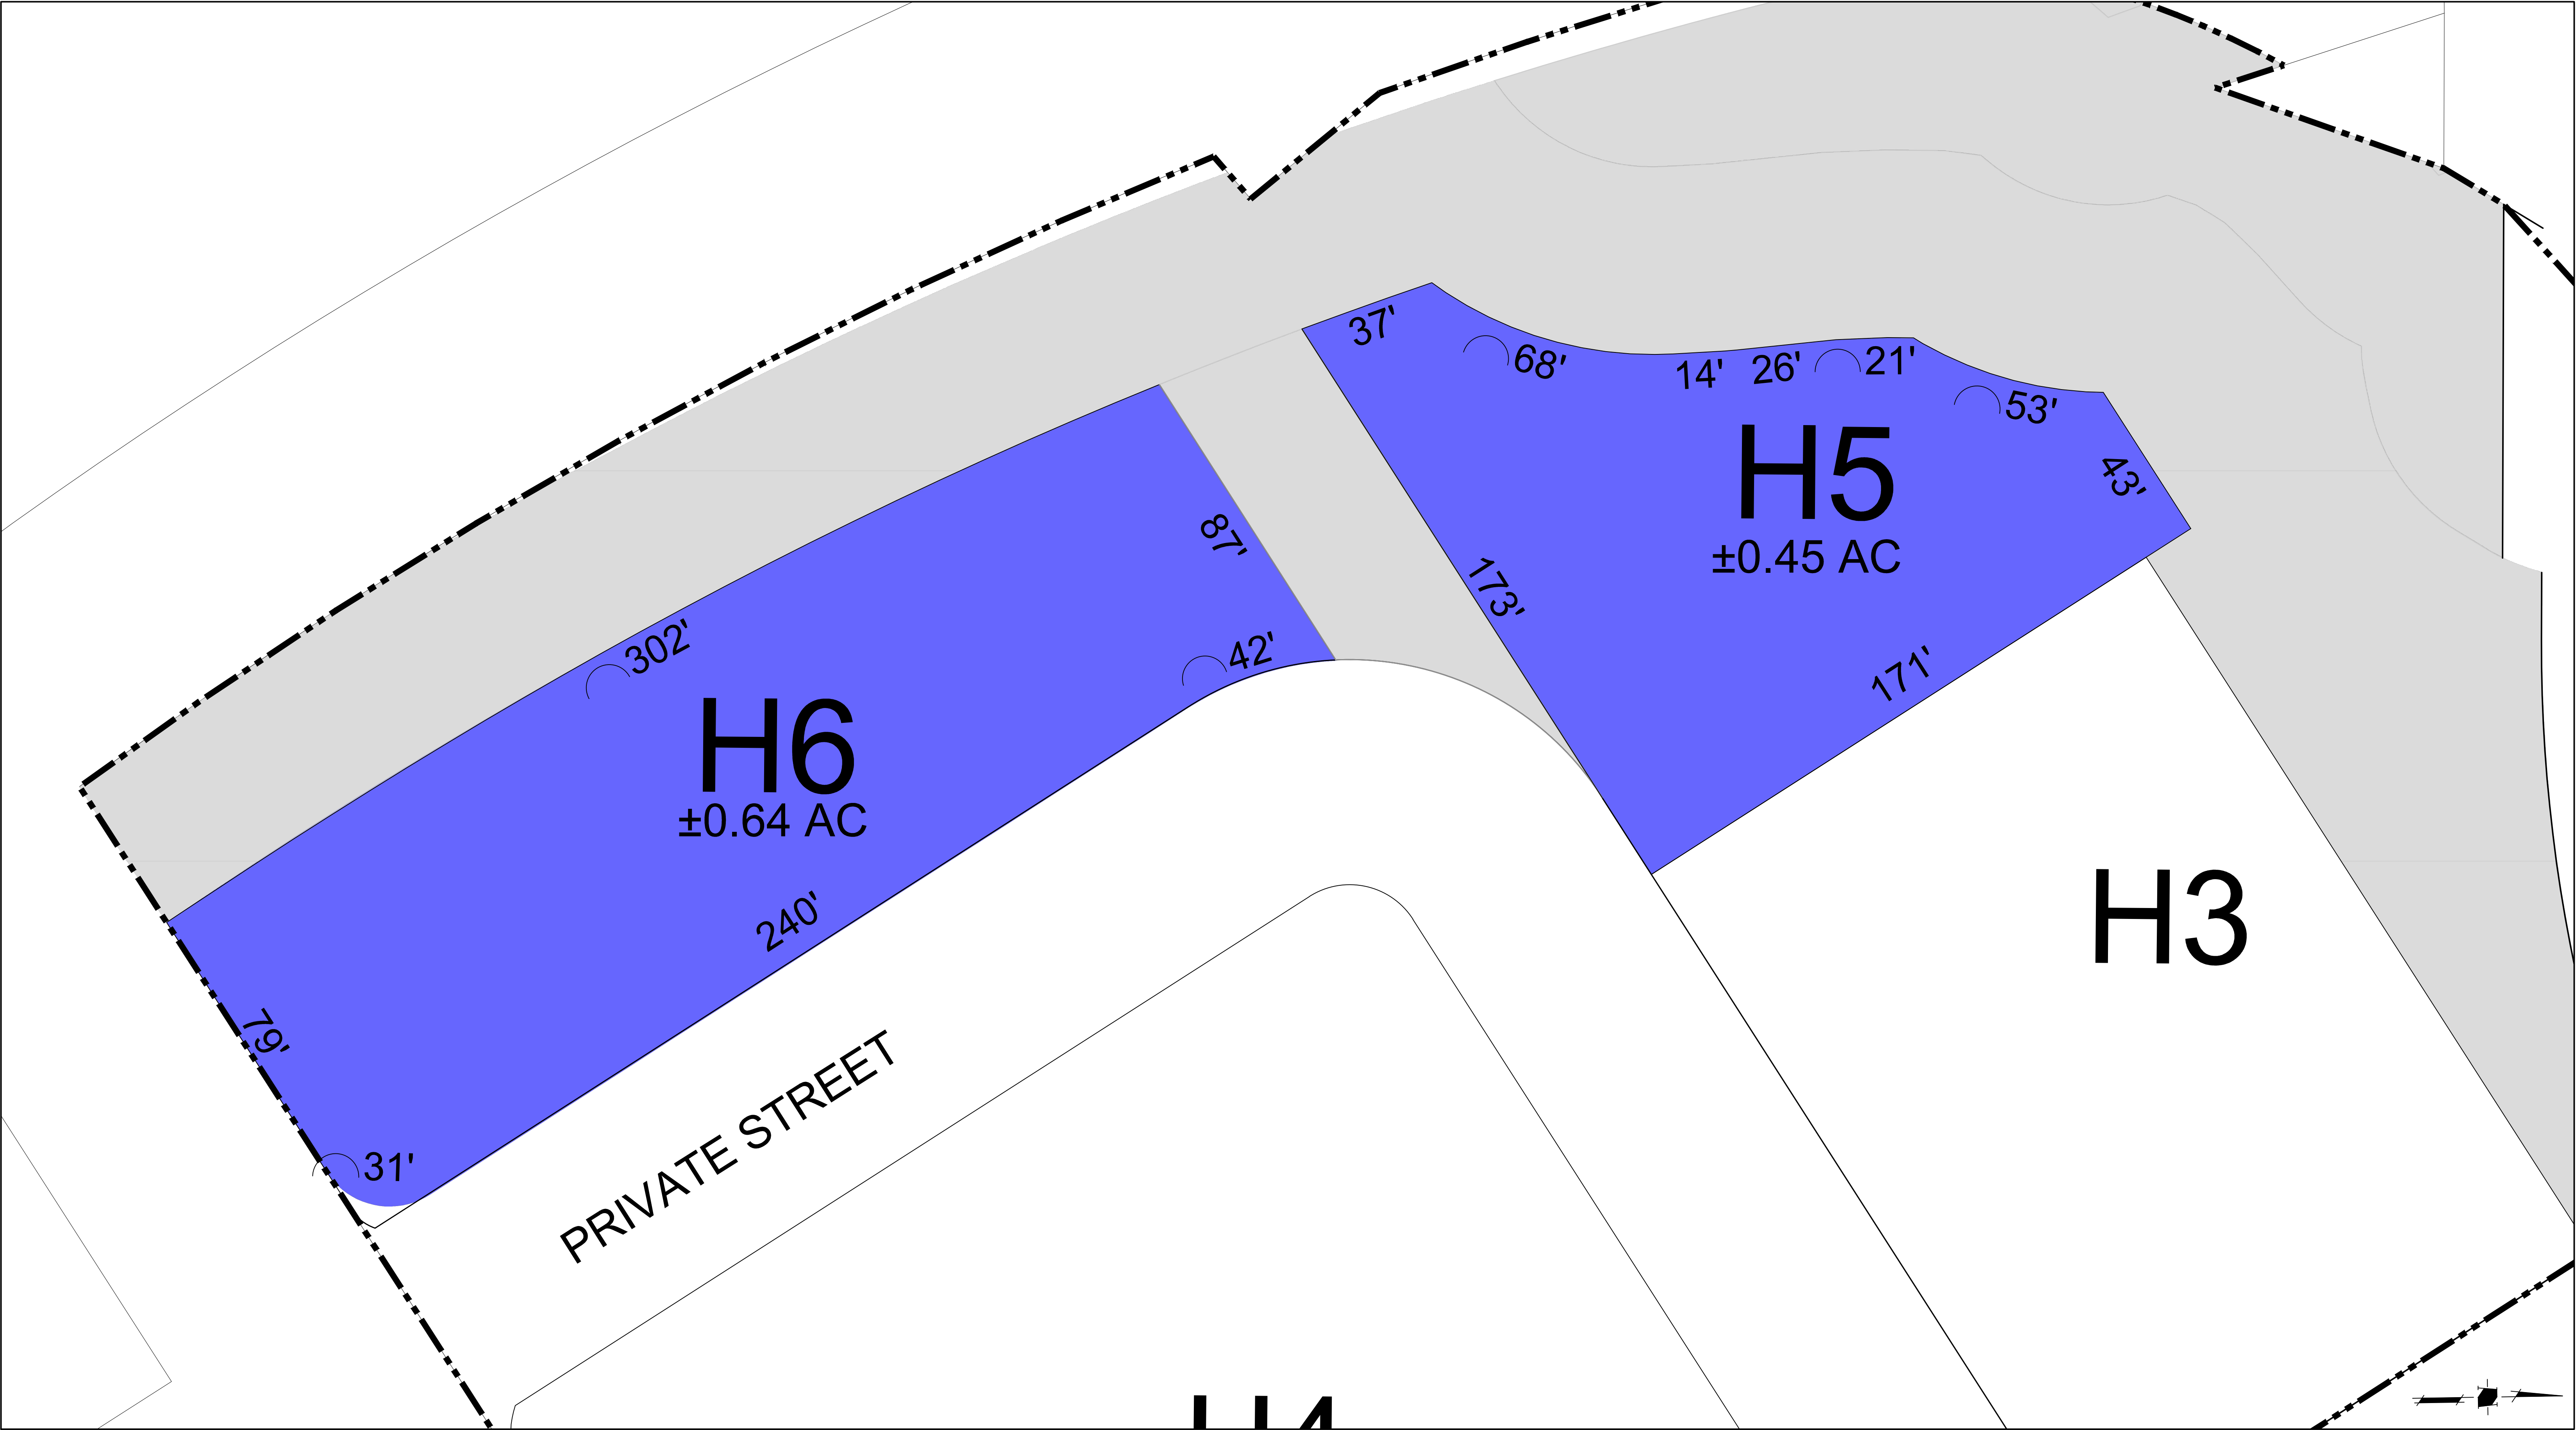

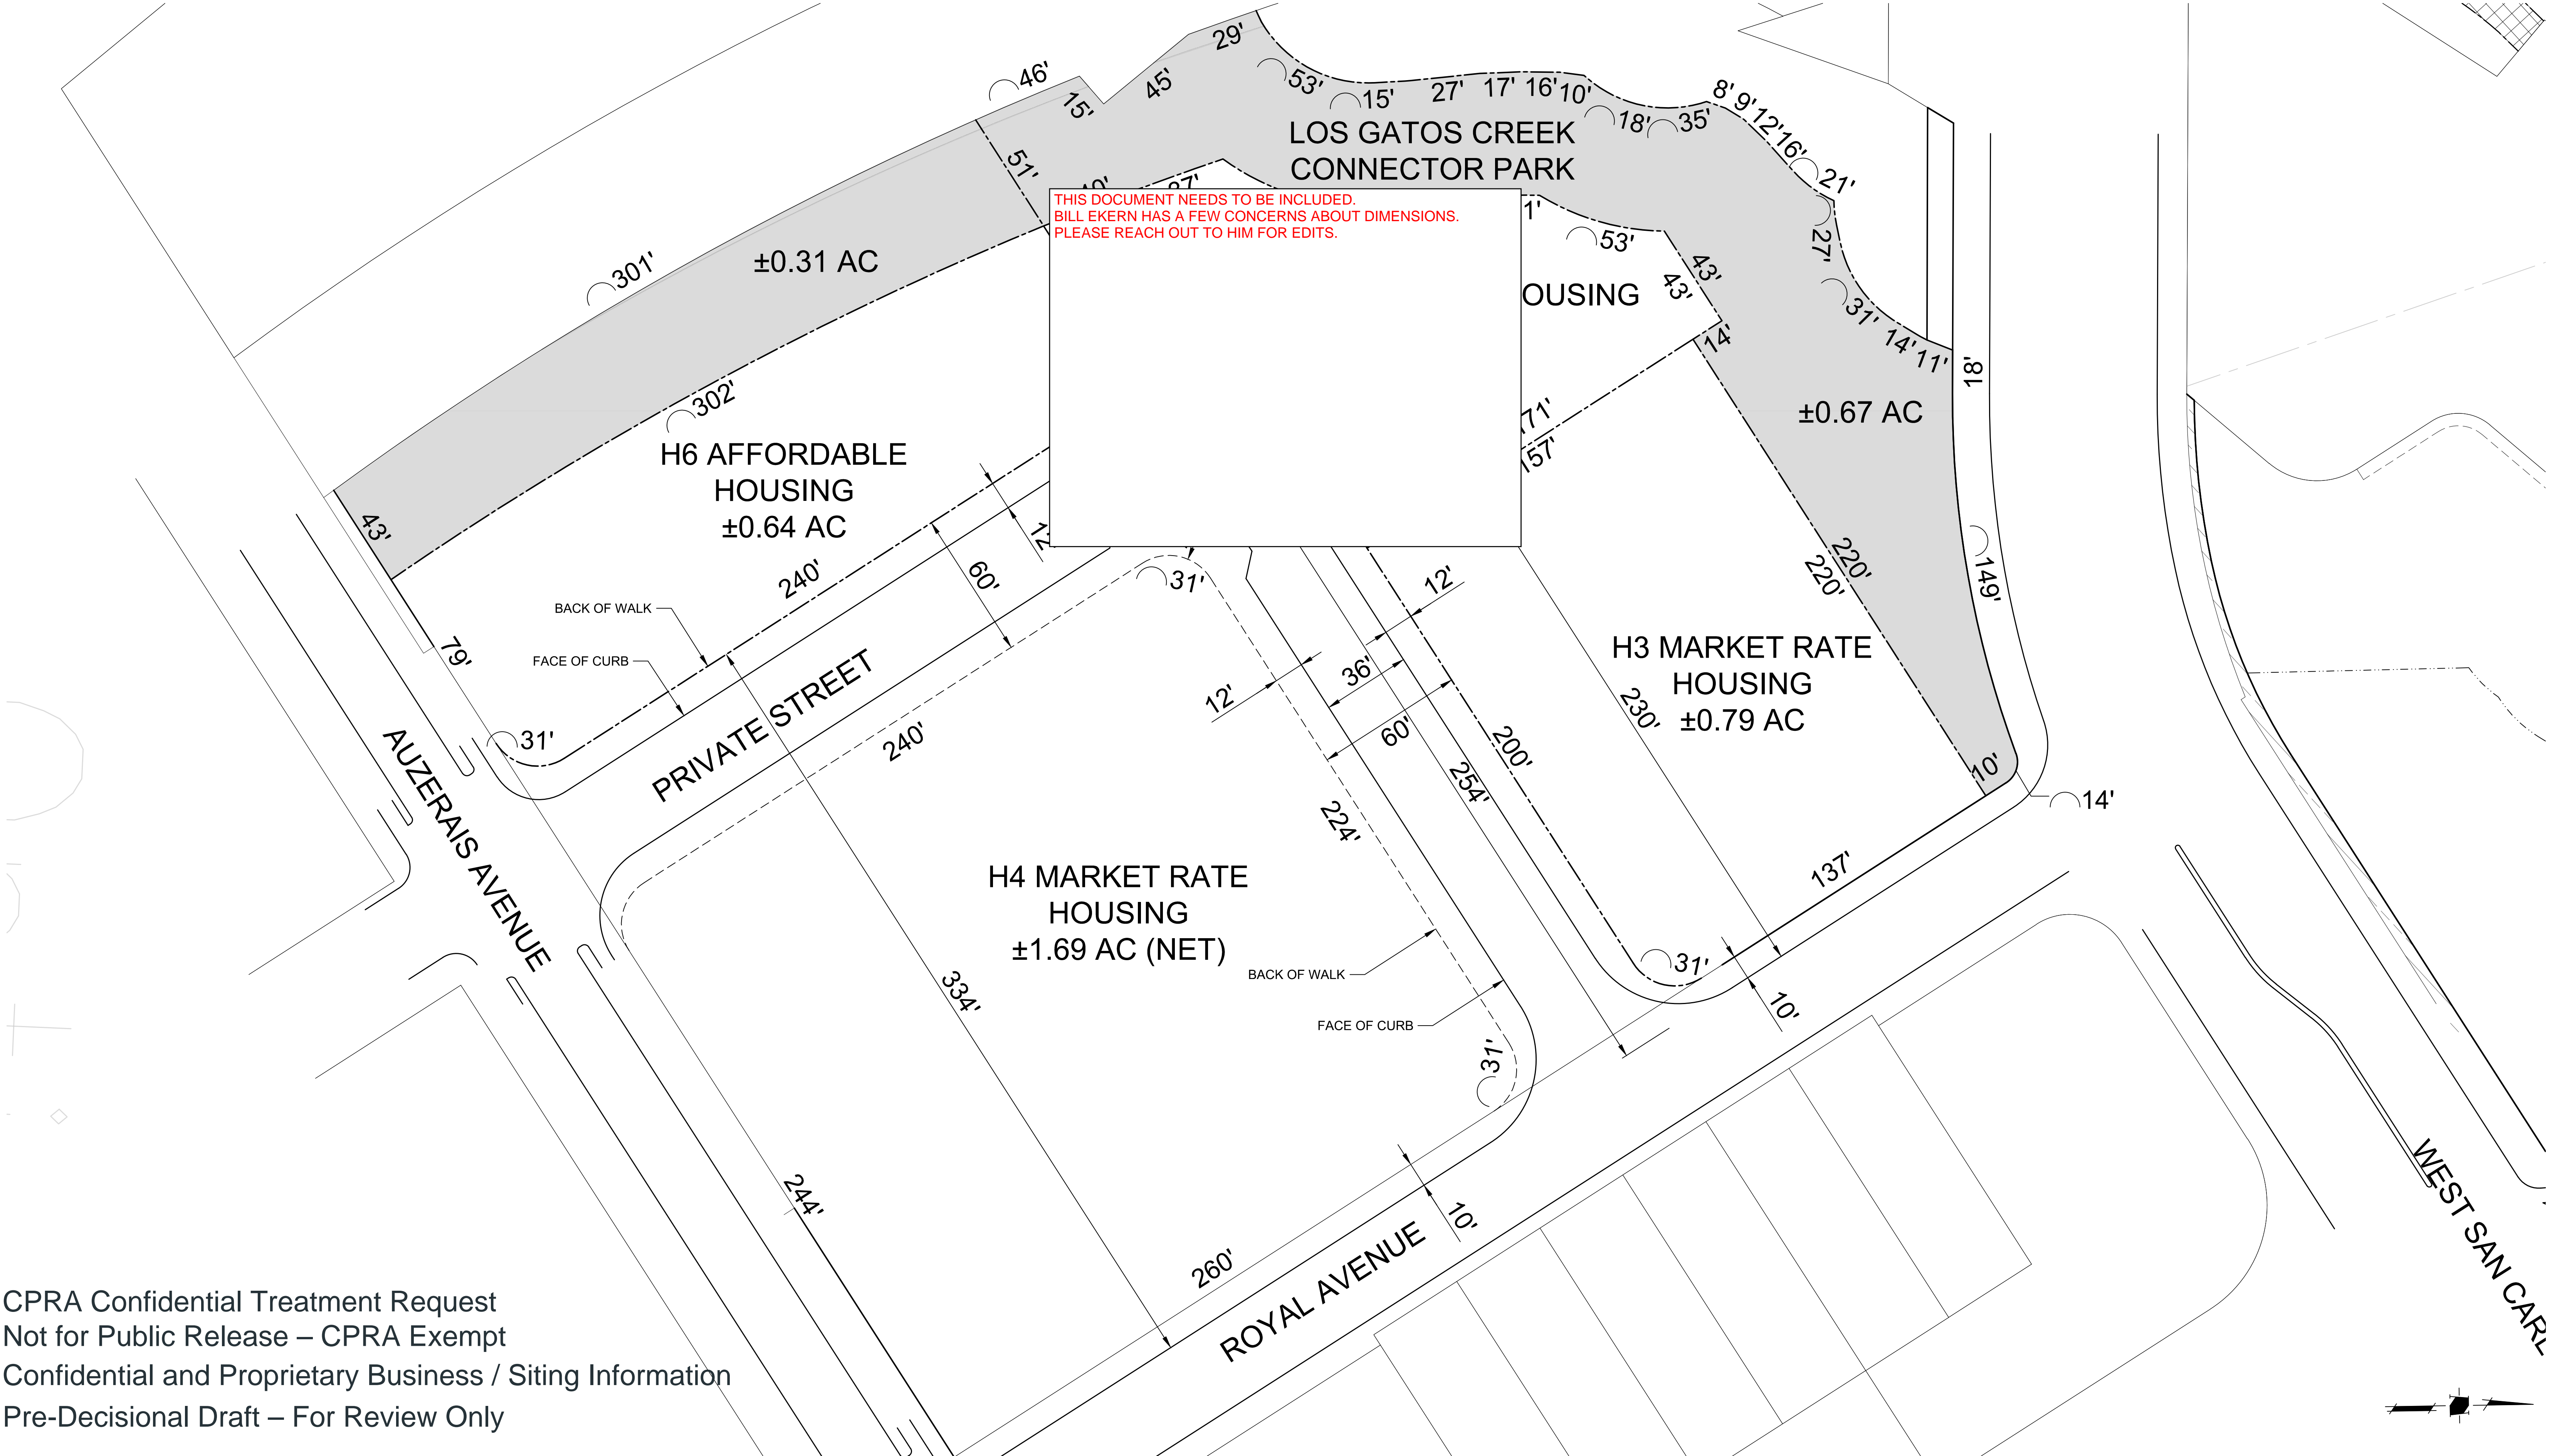

CPRA Confidential Treatment Request
Not for Public Release – CPRA Exempt
Confidential and Proprietary Business / Siting Information
Pre-Decisional Draft – For Review Only



1570 Oakland Road
San Jose, CA 95131
(408) 487-2200
HMHca.com



H BLOCK
Scale: 1" = 30'

Drawn: DMJ Reviewed: DM
HMH#5719.00 | 02/11/21